


\$2572.50

\$1733.51 (3/1) - 4/30

\$1785.52 5/1 - 4/30
20/20

\$838.99
diff.

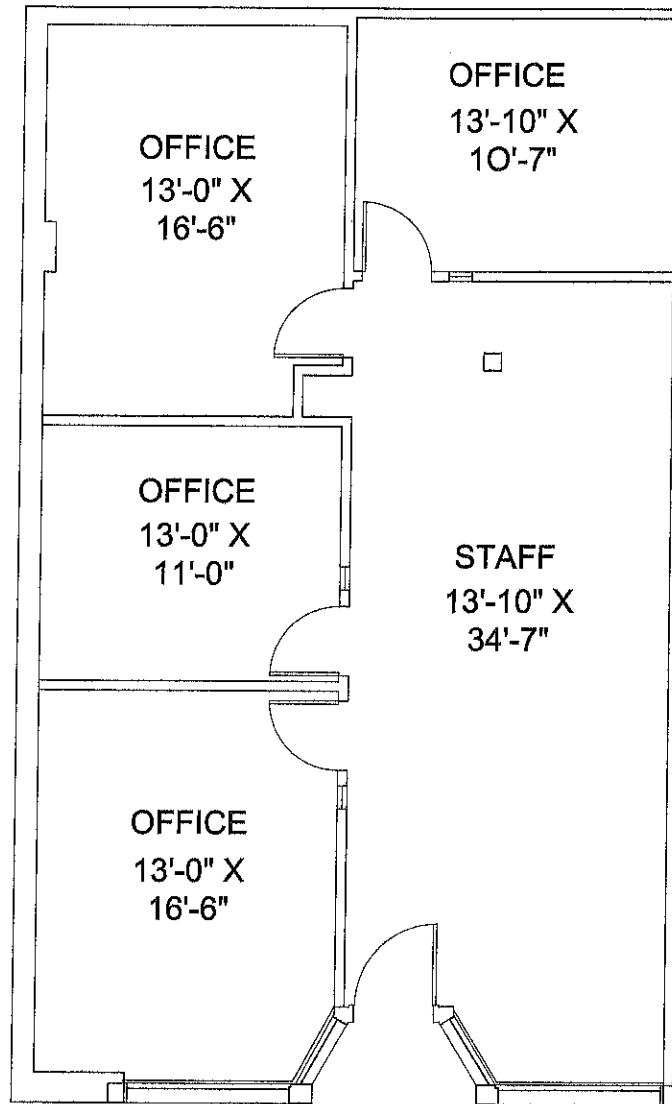

SUITE 920V

SUITE 920V
1295.54 USF
1470.44 RSF




NOTE:
Dimensions
are only
approximate

WATERCOURT

920 Hampshire Road
Westlake Village, California

AS-BUILT PLAN
SUITE 920V

Oct 08, 2016

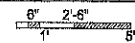

SCALE

AB-2a

File: Water920V